


NOTES

1. THE PURPOSE OF THIS PLAN IS TO SHOW THE PARTIAL AS-BUILT CONDITIONS OF THE MATTRESS FIRM SITE AS OF FEBRUARY 5, 2016.

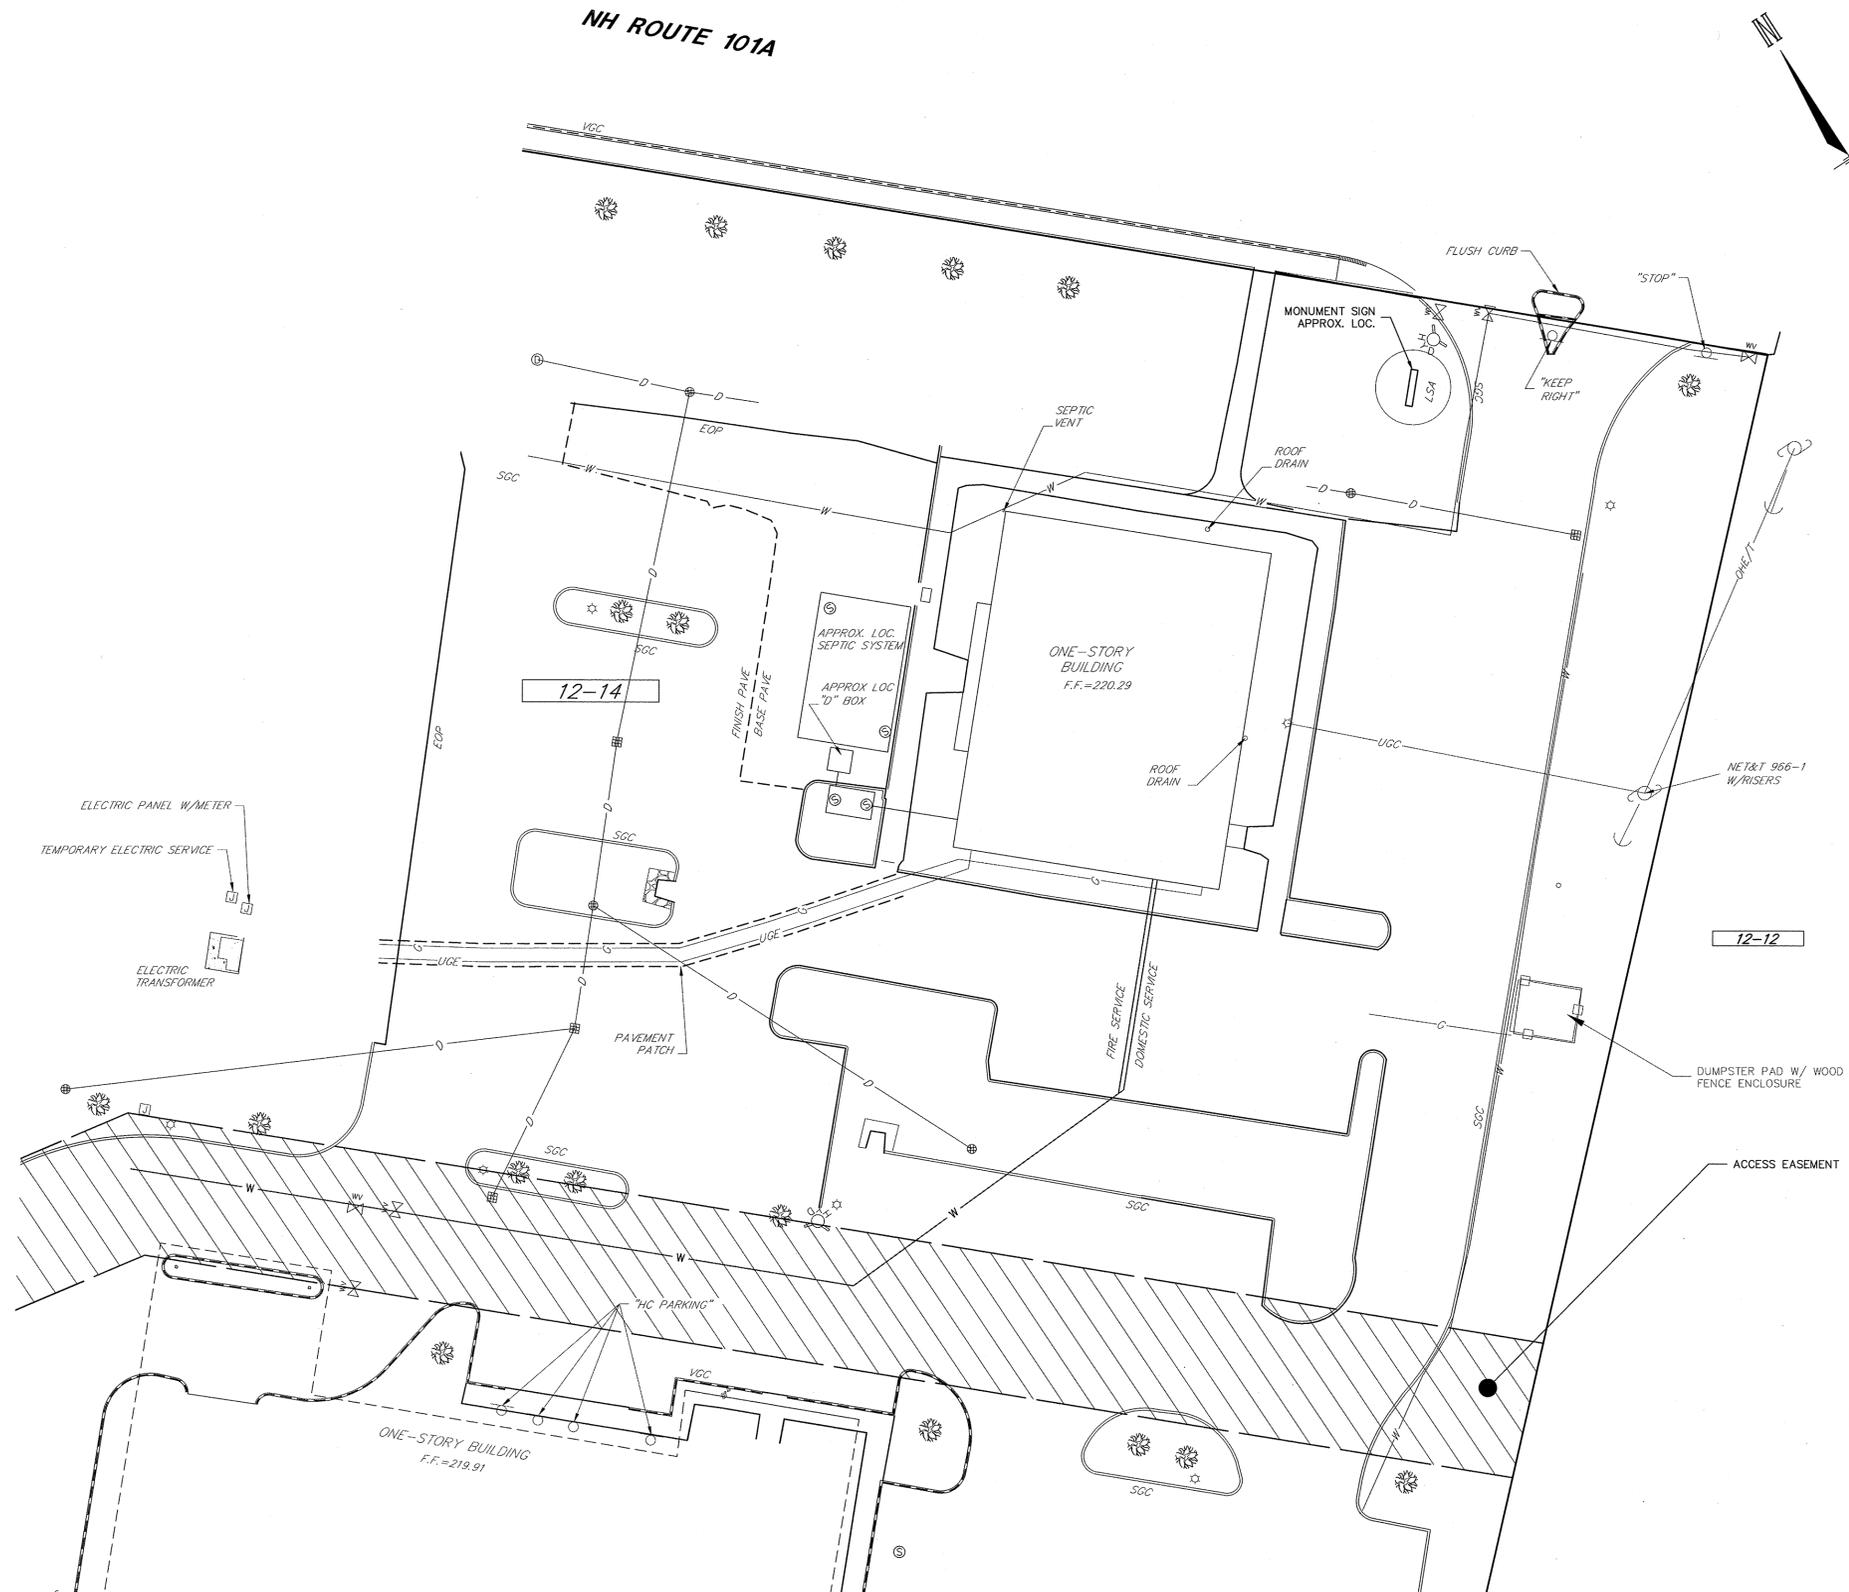


LEGEND


- STONE BOUND □
- IRON PIPE / ROD ○
- EDGE OF PAVEMENT —
- SLOPED GRANITE CURB =
- VERTICAL GRANITE CURB =
- SIGN ⊕
- GAS GATE ⊗
- LIGHT POLE ⊙
- HYDRANT ⊕
- TELEPHONE MANHOLE ⊕
- SEWER MANHOLE ⊕
- DRAIN MANHOLE ⊕
- CATCH BASIN - SQ. GRATE ⊕
- CATCH BASIN - BEEHIVE GRATE ⊕
- WATER GATE ⊕
- WATER MANHOLE ⊕
- UTILITY POLE W/GUY WIRE ⊕
- OVERHEAD UTILITIES -OHW-

TAX MAP 12 LOT 14
PARTIAL AS-BUILT PLAN
AMHERST PLAZA
131 ROUTE 101A AMHERST, NH
 PREPARED FOR
CHARLES RIVER REALTY

SCALE: 1"=20' FEBRUARY 9, 2016

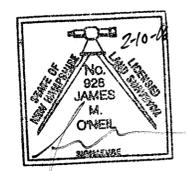

Copyright 2016 ©Thomas F. Moran, Inc.
 48 Constitution Drive, Bedford, N.H. 03110
 All rights reserved. These plans and materials may not be copied, duplicated, replicated or otherwise reproduced in any form whatsoever without the prior written permission of Thomas F. Moran, Inc.
 This plan is not effective unless signed by a duly authorized officer of Thomas F. Moran, Inc.

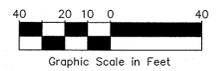

REV.	DATE	DESCRIPTION	DR	CK

TFM	Civil Engineers	48 Constitution Drive	
	Structural Engineers	Bedford, NH 03110	
	Traffic Engineers	Phone (603) 472-4488	
	Land Surveyors	Fax (603) 472-9747	
	Landscape Architects	www.tfmoran.com	
	Scientists		
76463.12	DR JMO	FB 2045/45	SHEET 1 OF 1
	CK JMO	CADFILE 76463-12 AsBuilt	